



EXISTING FLOOR PLAN

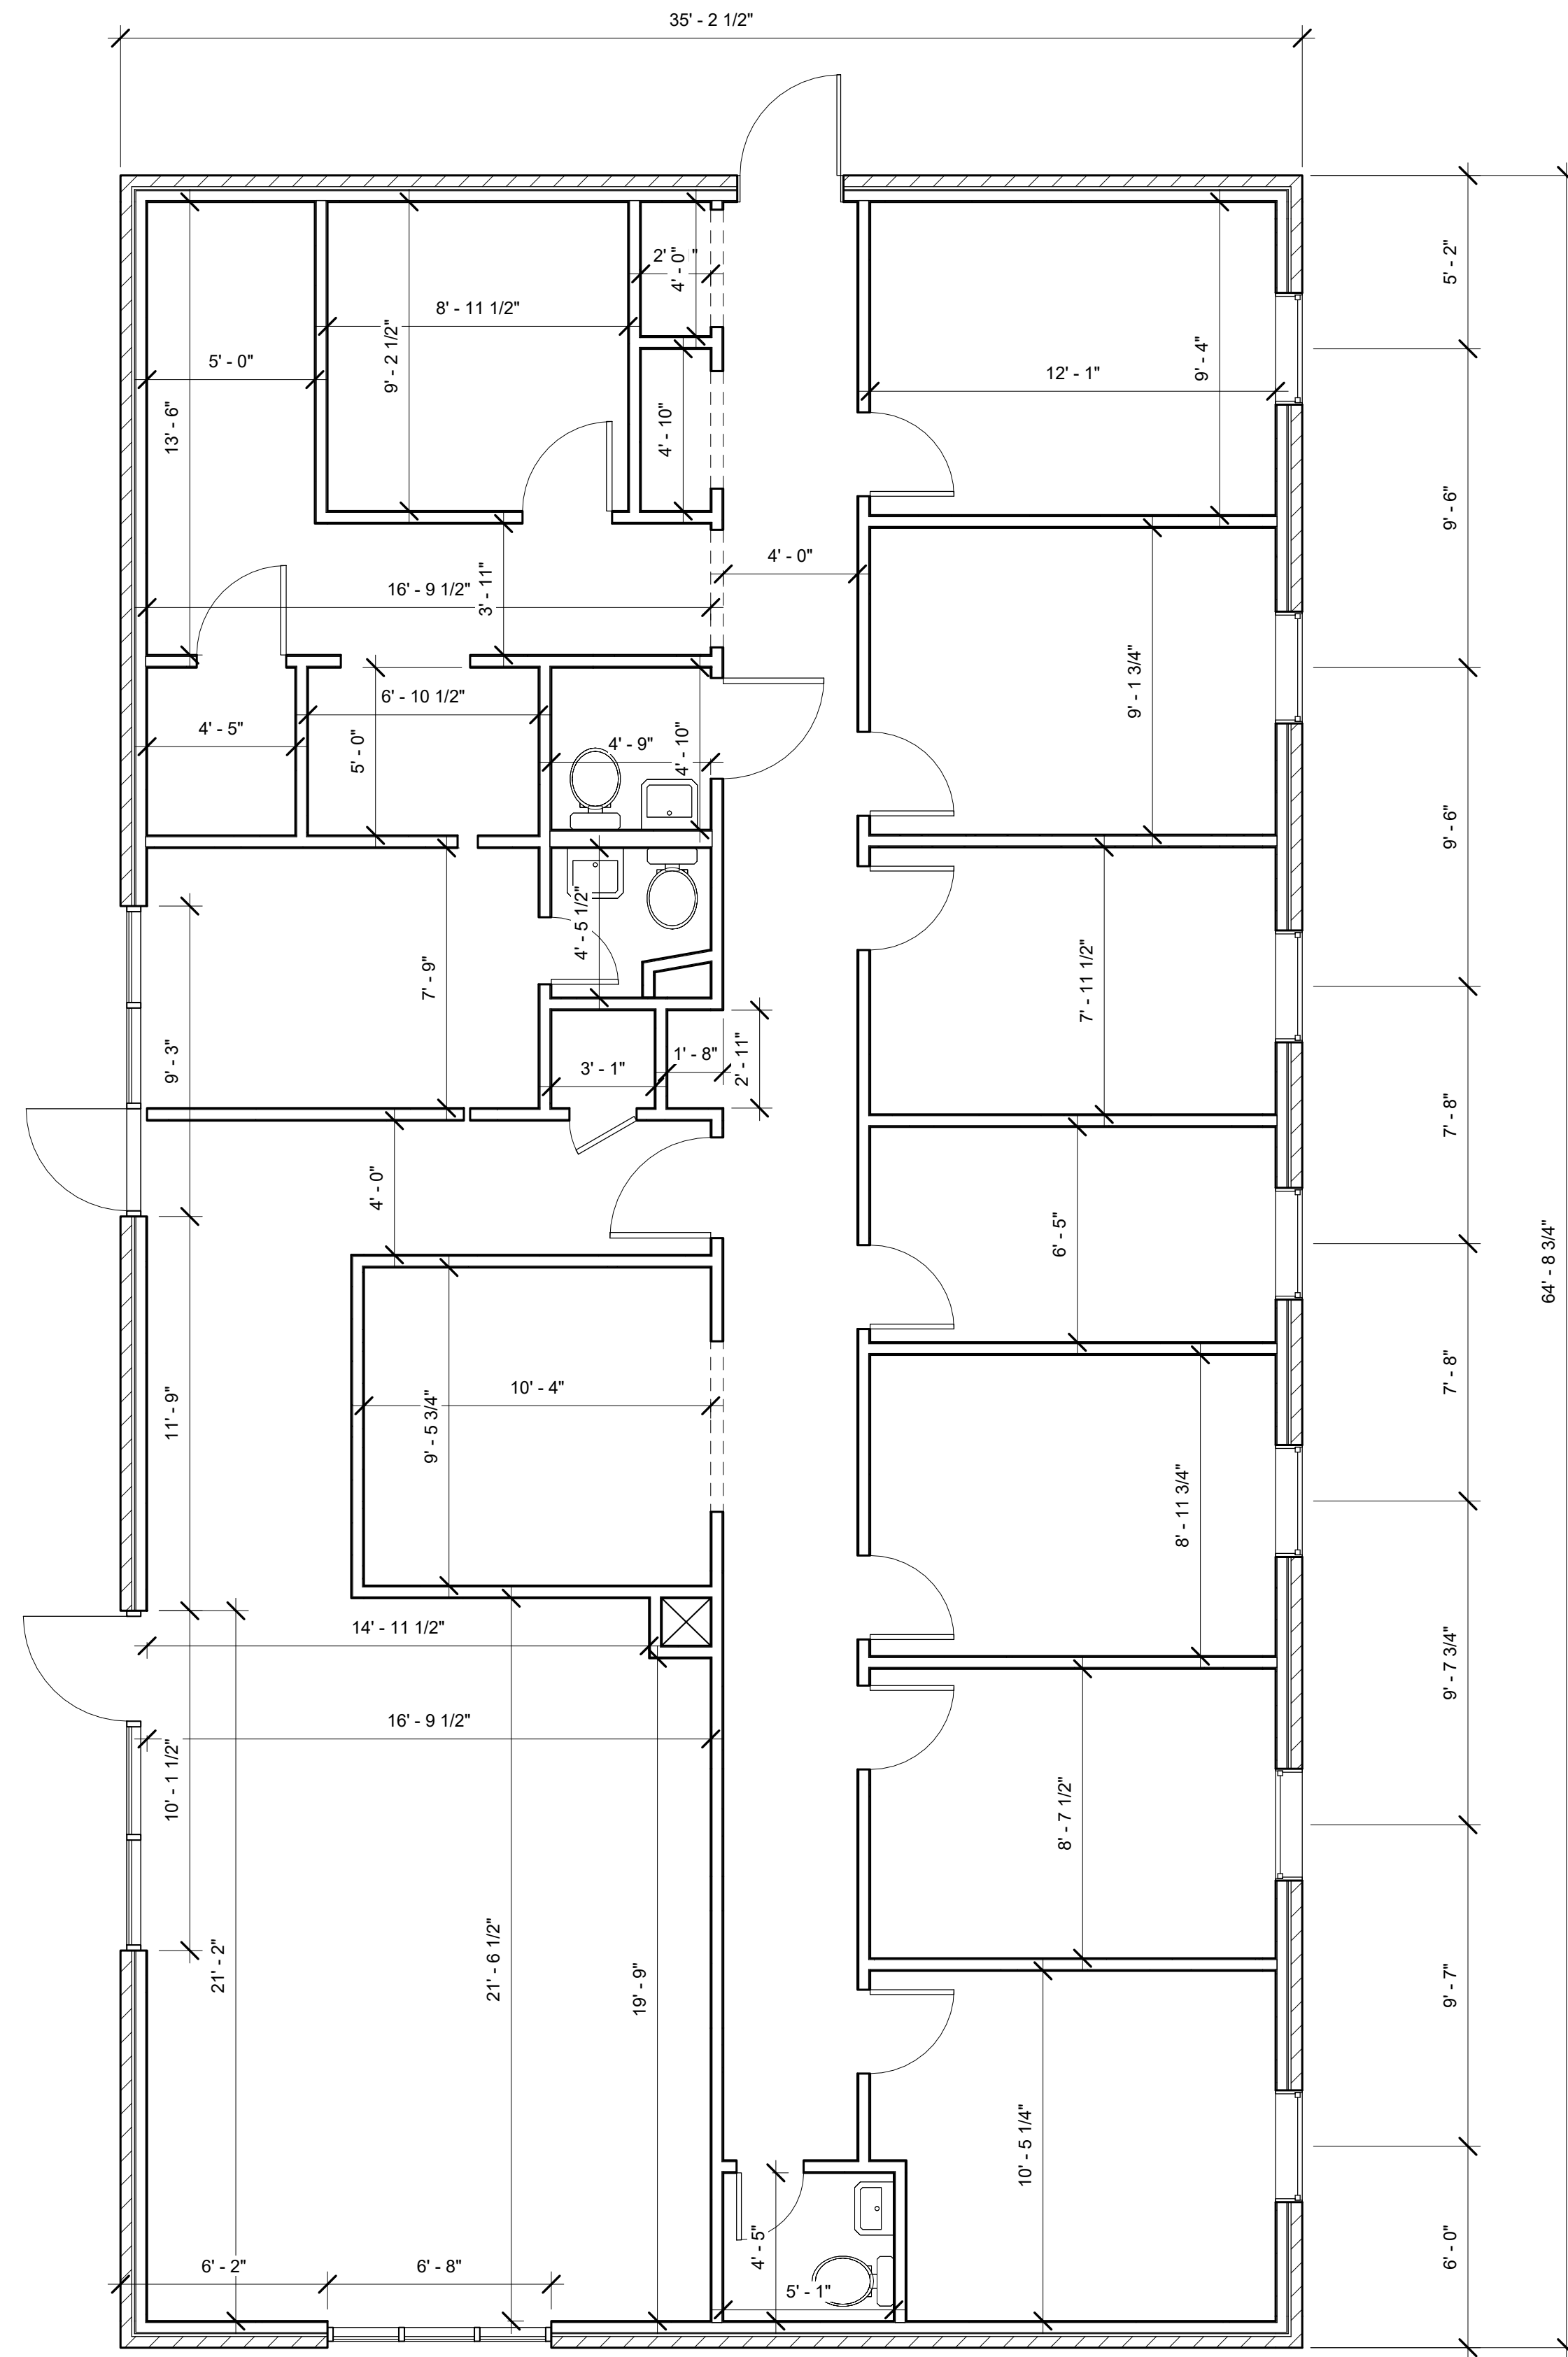


2 EXISTING PLAN
1/4" = 1'-0"

TEST FIT CONCEPT

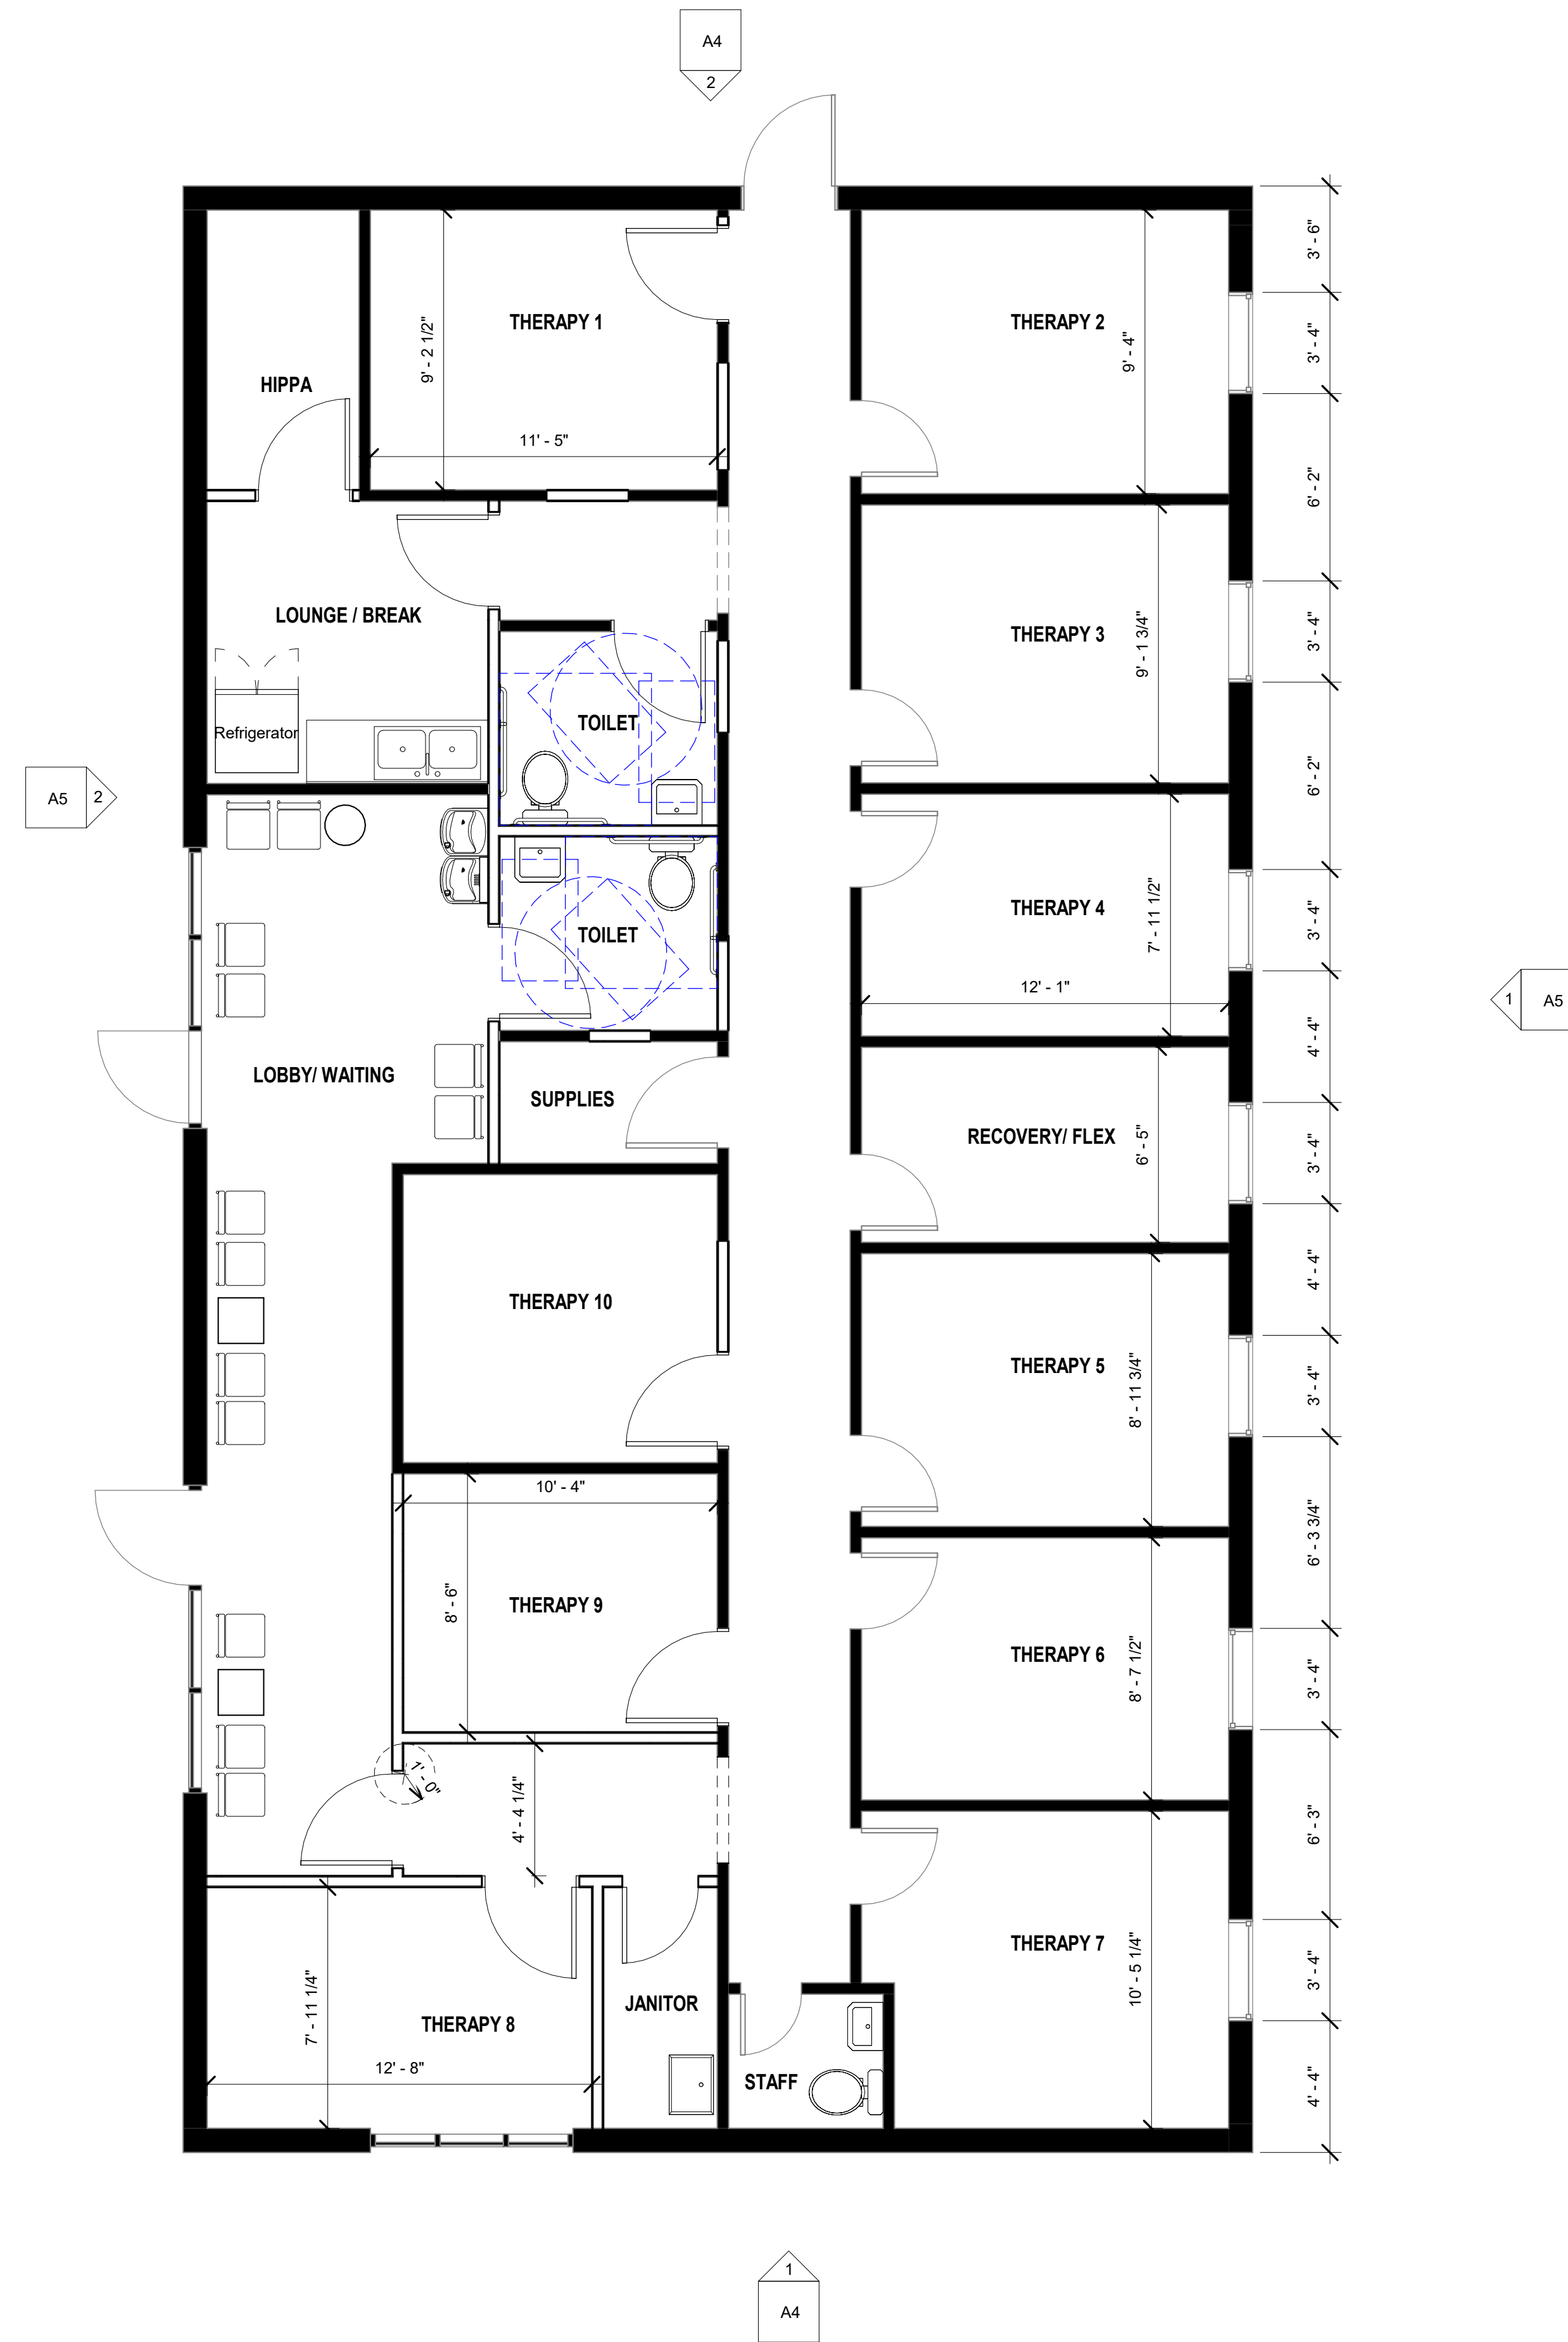

1 Level 1
1/4" = 1'-0"

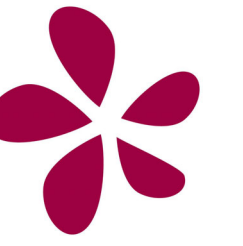

WILDFLOWER
DESIGN STUDIO

© 2021 COPYRIGHT WILDFLOWER DESIGN STUDIO PC
THIS DRAWING IS AN INSTRUMENT OF SERVICE UNIQUE
TO THIS PROJECT. IT IS NOT TO BE REUSED OR
REPRODUCED IN WHOLE OR IN PART WITHOUT
WRITTEN PERMISSION FROM THE ARCHITECT.



**PRELIMINARY
NOT FOR
CONSTRUCTION**

No.	Description	Date

MICHAEL KRAMER
108 W CHURCH ST.
FIRST FLOOR PLAN

Project number	24-028
Date	Issue Date
Drawn by	JAB
Checked by	JAB

A1

Scale 1/4" = 1'-0"